

RIOT GLASS, INC. TEST REPORT

SCOPE OF WORK HUMAN IMPACT TESTING CONDUCTED ON AN AP-25 IMPACT PROTECTION SYSTEM

REPORT NUMBER M0618.01-303-44


TEST DATE 03/02/21

ISSUE DATE 03/05/21

RECORD RETENTION END DATE 03/02/25

PAGES 13

DOCUMENT CONTROL NUMBER ATI 00231 (09/05/17) RT-R-AMER-Test-2827 © 2017 INTERTEK

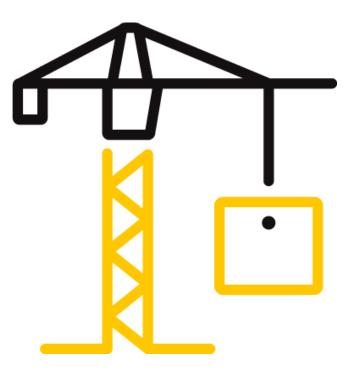



25800 Commercentre Drive Lake Forest, California 92630

Telephone: 949-460-9600 Facsimile: 717-764-4129 www.intertek.com/building

TEST REPORT FOR RIOT GLASS, INC.

Report No.: M0618.01-303-44 Date: 03/05/21

REPORT ISSUED TO

RIOT GLASS, INC. 17941 Brookshire Lane Huntington Beach, California 92647

SECTION 1

SCOPE

Products:

Intertek Building & Construction (B&C) was contracted by Riot Glass, Inc., Huntington Beach, California, to perform testing in accordance with AAMA 501.8 – Standard Test Method for Determination of Resistance to Human Impact of Window Systems Intended for Use in Psychiatric Applications on their AP-25 Protection System. Testing was conducted at Intertek B&C test facility in Fresno, California.

This report does not constitute certification of this product nor an opinion or endorsement by this laboratory.

SECTION 2

SUMMARY OF TEST RESULTS

Product Type: Protection System Series/Model: AP-25

TITLE		RESULTS	
Impacts	Met performance requirements.		
For INTERTEK B&C	:		
COMPLETED BY:	Aaron Baker	REVIEWED BY:	Jarod Hardman
TITLE:	Technician Team Lead	TITLE:	Operations Manager
SIGNATURE:		SIGNATURE:	
DATE:	03/05/21	DATE:	03/05/21
JSH:ab			

This report is for the exclusive use of Intertek's Client and is provided pursuant to the agreement between Intertek and its Client. Intertek's responsibility and liability are limited to the terms and conditions of the agreement. Intertek assumes no liability to any party, other than to the Client in accordance with the agreement, for any loss, expense or damage occasioned by the use of this report. Only the Client is authorized to permit copying or distribution of this report and then only in its entirety. Any use of the Intertek name or one of its marks for the sale or advertisement of the tested material, product or service must first be approved in writing by Intertek. The observations and test results in this report are relevant only to the sample(s) tested. This report by itself does not imply that the material, product, or service is or has ever been under an Intertek certification program.



Telephone: 949-460-9600 Facsimile: 717-764-4129 www.intertek.com/building

TEST REPORT FOR RIOT GLASS, INC.

Report No.: M0618.01-303-44 Date: 03/05/21

SECTION 3

TEST METHOD

The specimens was evaluated in accordance with the following:

AAMA 501.8-14, Standard Test Method for Determination of Resistance to Human Impact of Window Systems Intended for Use in Psychiatric Applications

SECTION 4

MATERIAL SOURCE

The test specimen was provided by the client. Representative samples of the test specimen will be retained by Intertek B&C for a minimum of four years from the test completion date.

The specimen was installed into a Douglas-fir lined steel test buck. The rough opening allowed for a 1/4" shim space. The exterior perimeter of the window was sealed with silicone sealant.

SECTION 5

TEST SPECIMEN DESCRIPTIONS

Product Type: Protection System Series/Model: AP-25

Product Size(s):				
OVERALL AREA:	WIDTH	WIDTH		
6.1 m² (65.6 ft²)	millimeters	inches	millimeters	inches
Storefront Size	1934	76-1/8	3153	124-1/8
Panel Size	1829	72	3048	120

Storefront Frame Construction:

FRAME MEMBER	MATERIAL	DESCRIPTION
Head	Aluminum	Base extrusion, see attached Drawings Section 12.
Head	Aluminum	Glass stop extrusion, clipped to base extrusion, see attached Drawings Section 12.
Sill	Aluminum	Base extrusion, see attached Drawings Section 12.



Telephone: 949-460-9600 Facsimile: 717-764-4129 www.intertek.com/building

TEST REPORT FOR RIOT GLASS, INC.

Report No.: M0618.01-303-44 Date: 03/05/21

Storefront Frame Construction: (Continued)

FRAME MEMBER	MATERIAL	DESCRIPTION
Sill	Aluminum	Glazing channel insert extrusion, clipped to base extrusion, see attached Drawings Section 12.
Jambs	Aluminum	Base extrusion, clipped to base clip see attached Drawings Section 12.
Jambs	Aluminum	Base clip, see attached Drawings Section 12.
	JOINERY TYPE	DETAIL
All Corners	Flush	Dry fit corner

Note 1: Base curtain wall assembly consisted of non-impact rated system to confirm performance and compliance of tested AP-25 system for protection.

Protective System Frame Construction.			
FRAME MEMBER	PART #	MATERIAL	DESCRIPTION
Base	A-09003	Aluminum	0.060" extrusion, secured to system with self-tapping tamper resistant screws, see attached Drawings Section 12.
Wedge	A-09902	Aluminum	Secured to face of AP-25 system into base with supplied self-tapping tamper resistant screws 6" on center and 2" from end spacing, see attached Drawings Section 12.
Сар	A-09005	Aluminum	0.040" extrusion, press fit over wedge, see attached Drawings Section 12.
	JOINERY TY	(PE	DETAIL
All Corners	Flush		Dry fit corners

Protective System Frame Construction:

Reinforcement: No reinforcement was utilized.

Weatherstripping: No weatherstripping was utilized.



Telephone: 949-460-9600 Facsimile: 717-764-4129 www.intertek.com/building

TEST REPORT FOR RIOT GLASS, INC.

Report No.: M0618.01-303-44 Date: 03/05/21

Glazing: No conclusions of any kind regarding the adequacy or inadequacy of the glass in any glazed test specimen(s) can be made.

GLASS TYPE	GLAZING	GLAZING METHOD
Monolithic	1/4" Clear Tempered	Exterior set, dry fit with wedge gasket.

PROTECTIVE SYSTEM	GLAZING	GLAZING METHOD
Armorplast 25 (AP-25)	1/4" Clear Polycarbonate	Dry fit with wedge and cover cap.

LOCATION	QUANTITY	DAYLIGHT OPENING		GLASS BITE
		millimeters inches		
Fixed lite	1	1708 x 3007	70-3/8 x 118-3/8	13/16"

Drainage: No drainage was utilized.

Hardware: No hardware was utilized.

Screen Construction: No screen was utilized.

SECTION 6

TEST RESULTS

The results are tabulated as follows:

Impact #	Impact Location	Results	Observations
1	Lower Left Corner	PASS	No visible damage
2	Center of Light	PASS	No visible damage
3	Center Right Edge	PASS	No visible damage

General Note: All testing was performed in accordance with the referenced standard.

Note #1: See Intertek-ATI Sketch #1 in Section 7 for impaction location.




TEST REPORT FOR RIOT GLASS, INC.

Report No.: M0618.01-303-44 Date: 03/05/21

SECTION 6

SKETCHES

Telephone: 949-460-9600 Facsimile: 717-764-4129 www.intertek.com/building

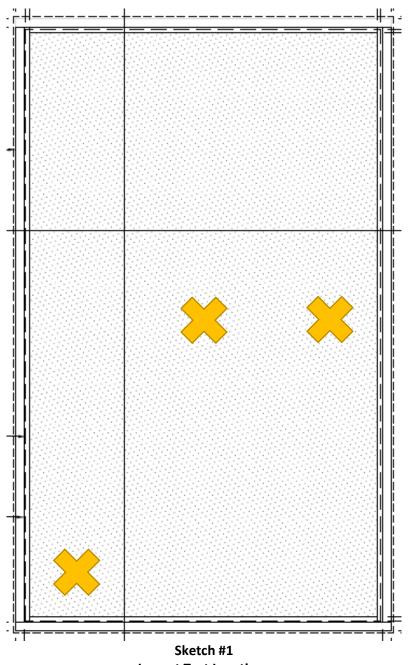

Impact Test Locations



25800 Commercentre Drive Lake Forest, California 92630

Telephone: 949-460-9600 Facsimile: 717-764-4129 www.intertek.com/building

TEST REPORT FOR RIOT GLASS, INC.

Report No.: M0618.01-303-44 Date: 03/05/21

SECTION 7

DRAWINGS

The test specimen drawings have been reviewed by Intertek B&C and are representative of the test specimen(s) reported herein. Test specimen construction was verified by Intertek B&C per the drawings included in this report. Any deviations are documented herein or on the drawings.





HURRICANE TESTING SPECIMIENS

SYSTEM(S) RIOT GLASS AP25 FULL FRAME, 1 1/8" TALL x 1 3/16" WIDE RIOT GLASS AP25 SURFACE MOUNT, 1 3/16" TALL x 1/2" WIDE SYSTEM CAN BE BACK GLAZED OR OVER GLAZED ONTO EXISTING WINDOWS FOR FORCED ENTRY PREVENTION, HURRICANE AND OTHER WINDSTORM PROTECTION. FINISH(ES) ALUMINUM FRAME FINISH AVAILABE FINISHES: • MILL FINISH CLEAR ANODIZED BRONZE ANODIZED CUSTOM POWDER COAT OR PAINT

RIOT GLASS, INC.

17941 BROOKSHIRE LANE HUNTINGTON BEACH, CA 92647 (800) 580 - 2303

GLAZING SCHEDULE

RIOT GLASS™ ARMORPLAST™ 25 (AP25) ¼" ACCESS DENIAL PANEL

MAX PANEL SIZE: 72" x 120"

ALL AP25 PANELS ARE AR1 COATED (80 MICRON THICK UV AND ABRASION RESISTANT ON ONE SIDE) UNLESS OTHERWISE NOTED.

AR1 COATING IS ON THE SIDE EXPOSED TO ANY WEATHER OR ABRASION. THE UNEXPOSED SIDE IS NOT COATED.


DRAWING INDEX

0.00	COVER SHEET & INDEX
0.01	PARTS LIST
2.01	STOREFRONT FRAMING ELEVATION
2.02	CURTAINWALL FRAMING ELEVATION (FULL FRAME)


DRAWING INDEX (CO

5.01	STOREFRONT HEAD AND SILL DETAILS (FULL FRAME
5.02	CURTAINWALL HEAD AND SILL DETAILS (FULL FRAME
6.01	STOREFRONT JAMB DETAILS (FULL FRAME)
6.02	CURTAINWALL JAMB DETAILS (FULL FRAME)


			ARCHITECT OF RECORD'S APPROVAL	!4"x36" PAPER
			STRUCTURAL ENGINEER OF RECORD'S APPROVAL	THIS DRAWING IS NOT TO SCALE IF NOT PRINTED ON 2
			STRUCTURAL ENGINEER'S APPROVAL	·
			GENERAL CONTRACTOR'S APPROVAL	
			REVISIONS B 1 SF DIMENSIONS CHANGED TO 1.75"x4.00" TG	
ONT.)				
:) =)				
			RIOT GLASS, INC. 17941 BROOKSHIRE LANE HUNTINGTON BEACH, CA 92647 (800) 580 - 2303	-
			RIOT GLASS FRAMING DETAILS AVAILABLE IN USA & CANADA	
			FULL FRAME SURFACE MOUNT	
			scale N/A	
			DRAWN TGM	1:02 PM
				3 PLOTTED 1/18/2021 9
	1	. !!	\ <i>J</i> \ <i>J</i> \ <i>J</i>	Ž

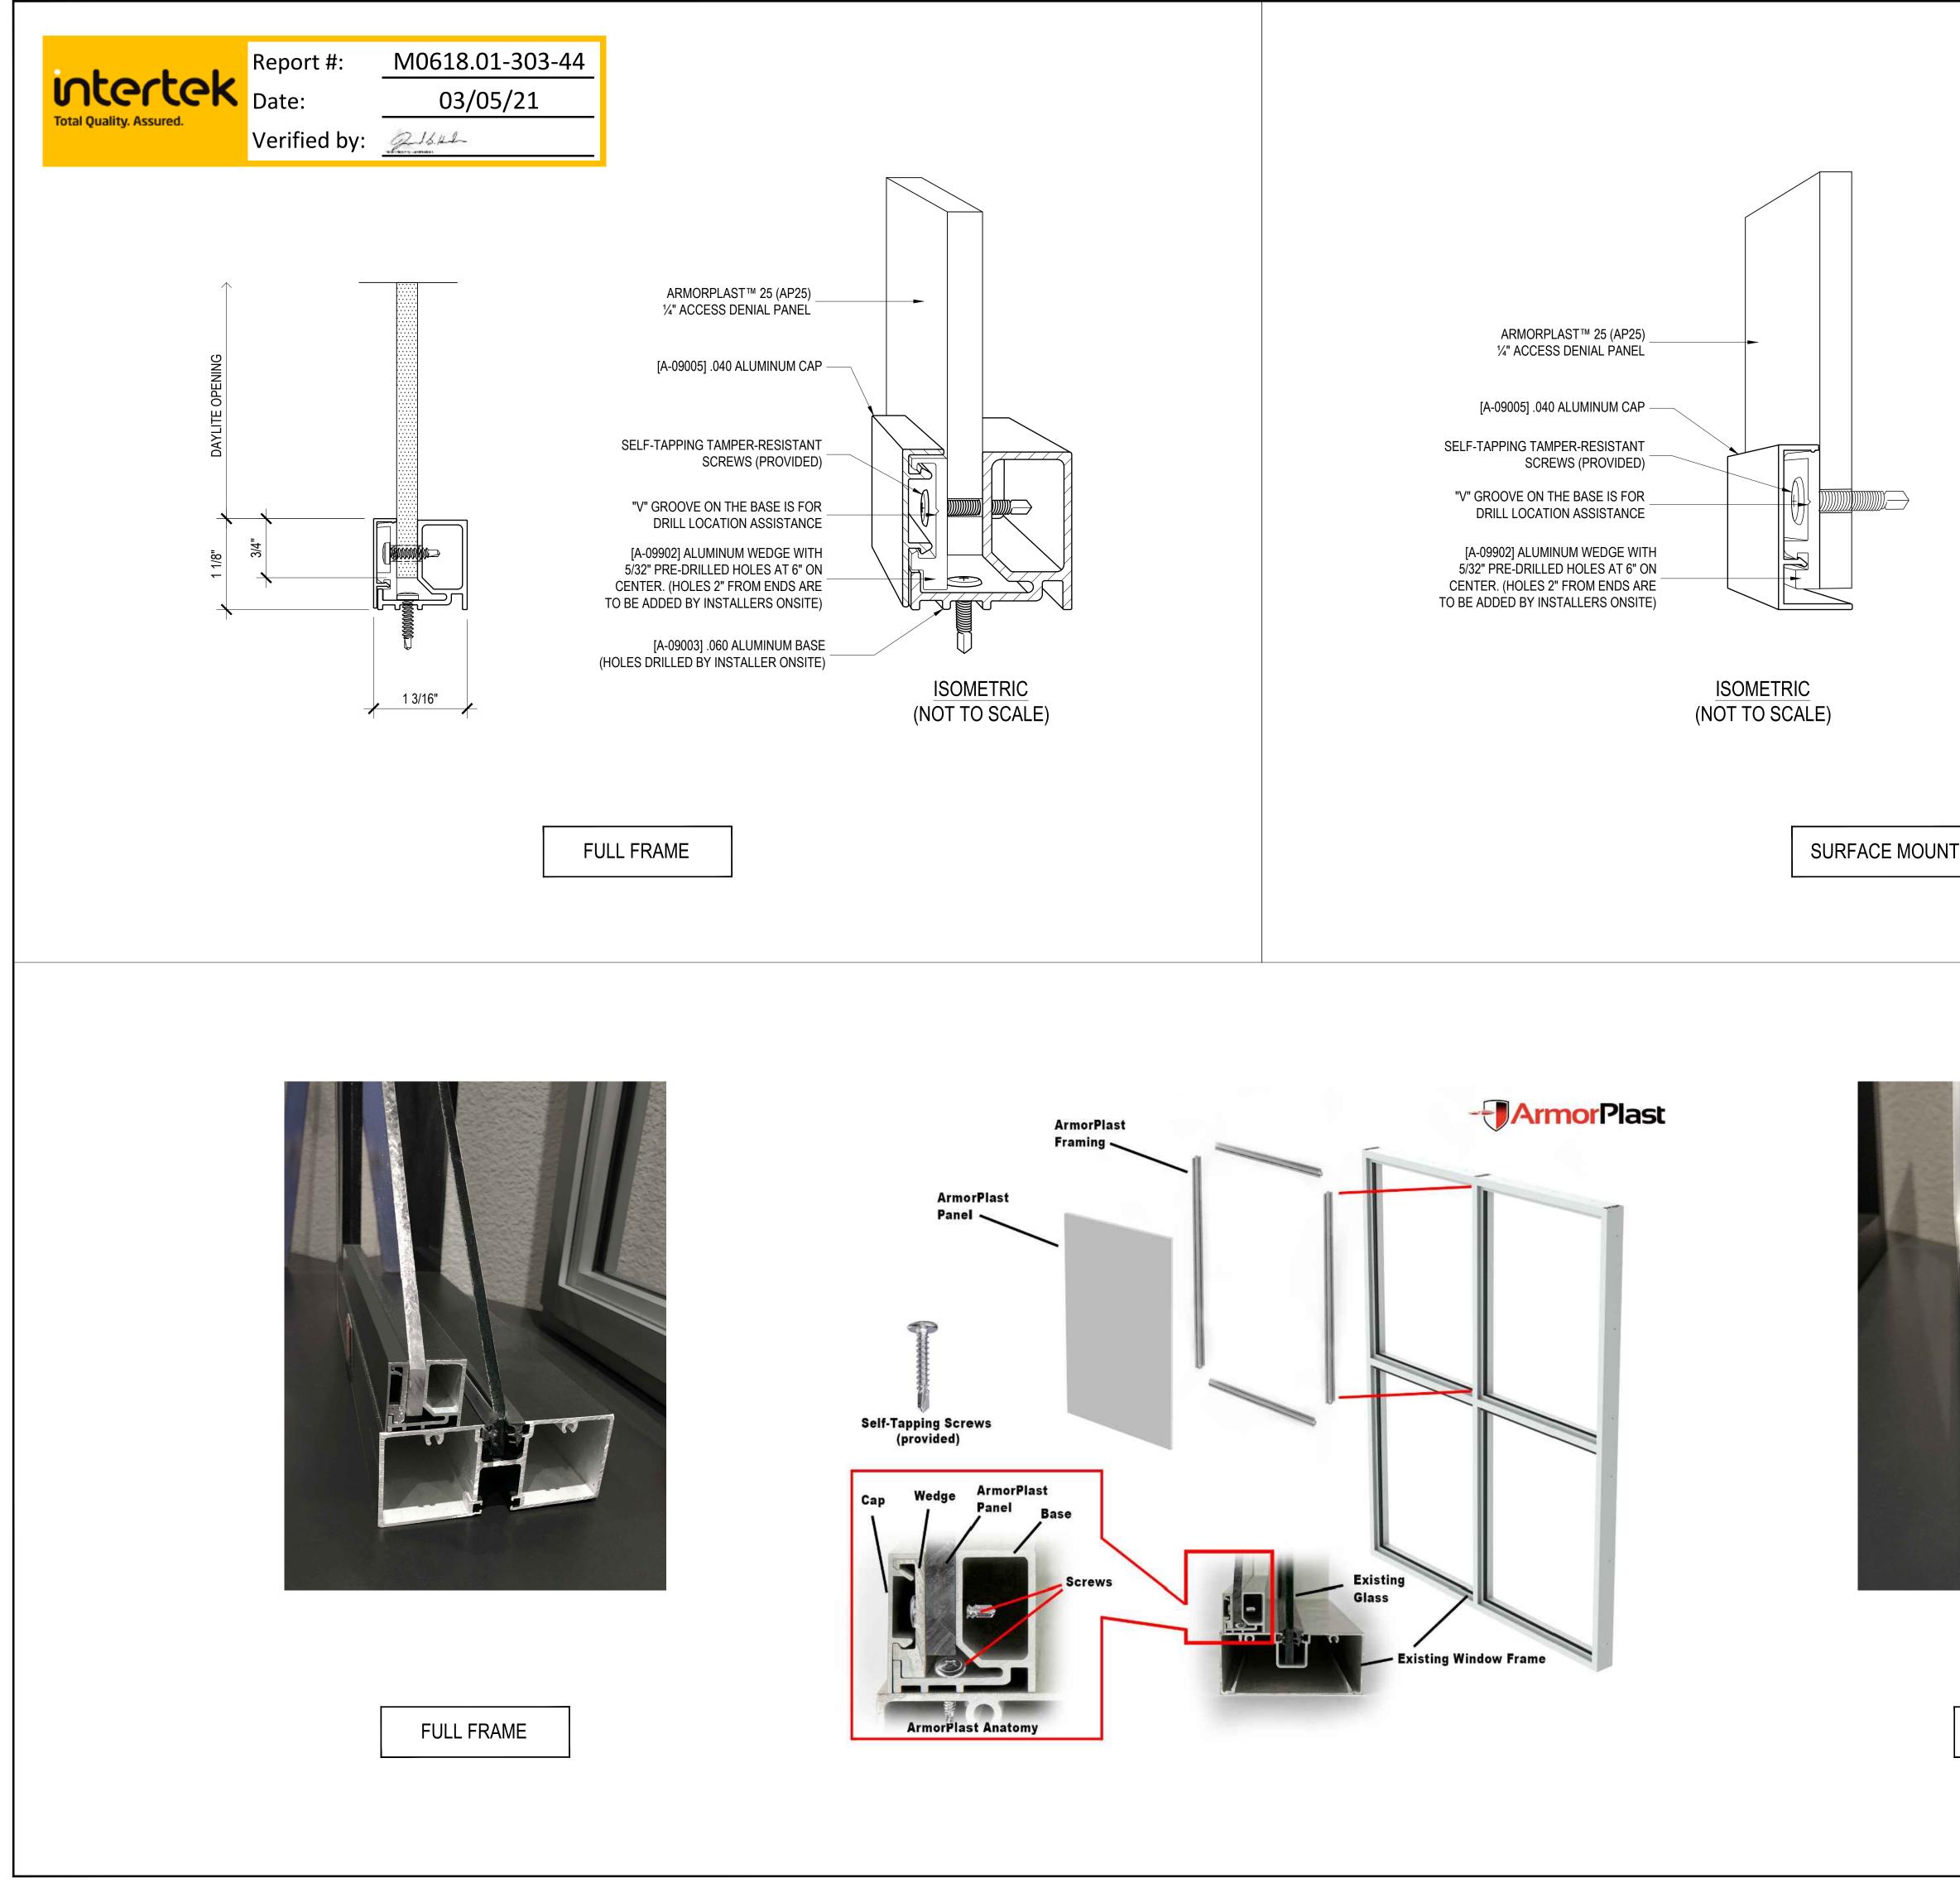


	ARCHITECT OF RECORD'S APPROVAL
	STRUCTURAL ENGINEER OF RECORD'S APPROVAL
	STRUCTURAL ENGINEER'S APPROVAL
	REVISIONS BY
	RIOT GLASS, INC. 17941 BROOKSHIRE LANE HUNTINGTON BEACH, CA 92647 (800) 580 - 2303
SURFACE MOUNT	FULL FRAME SURFACE MOUNT

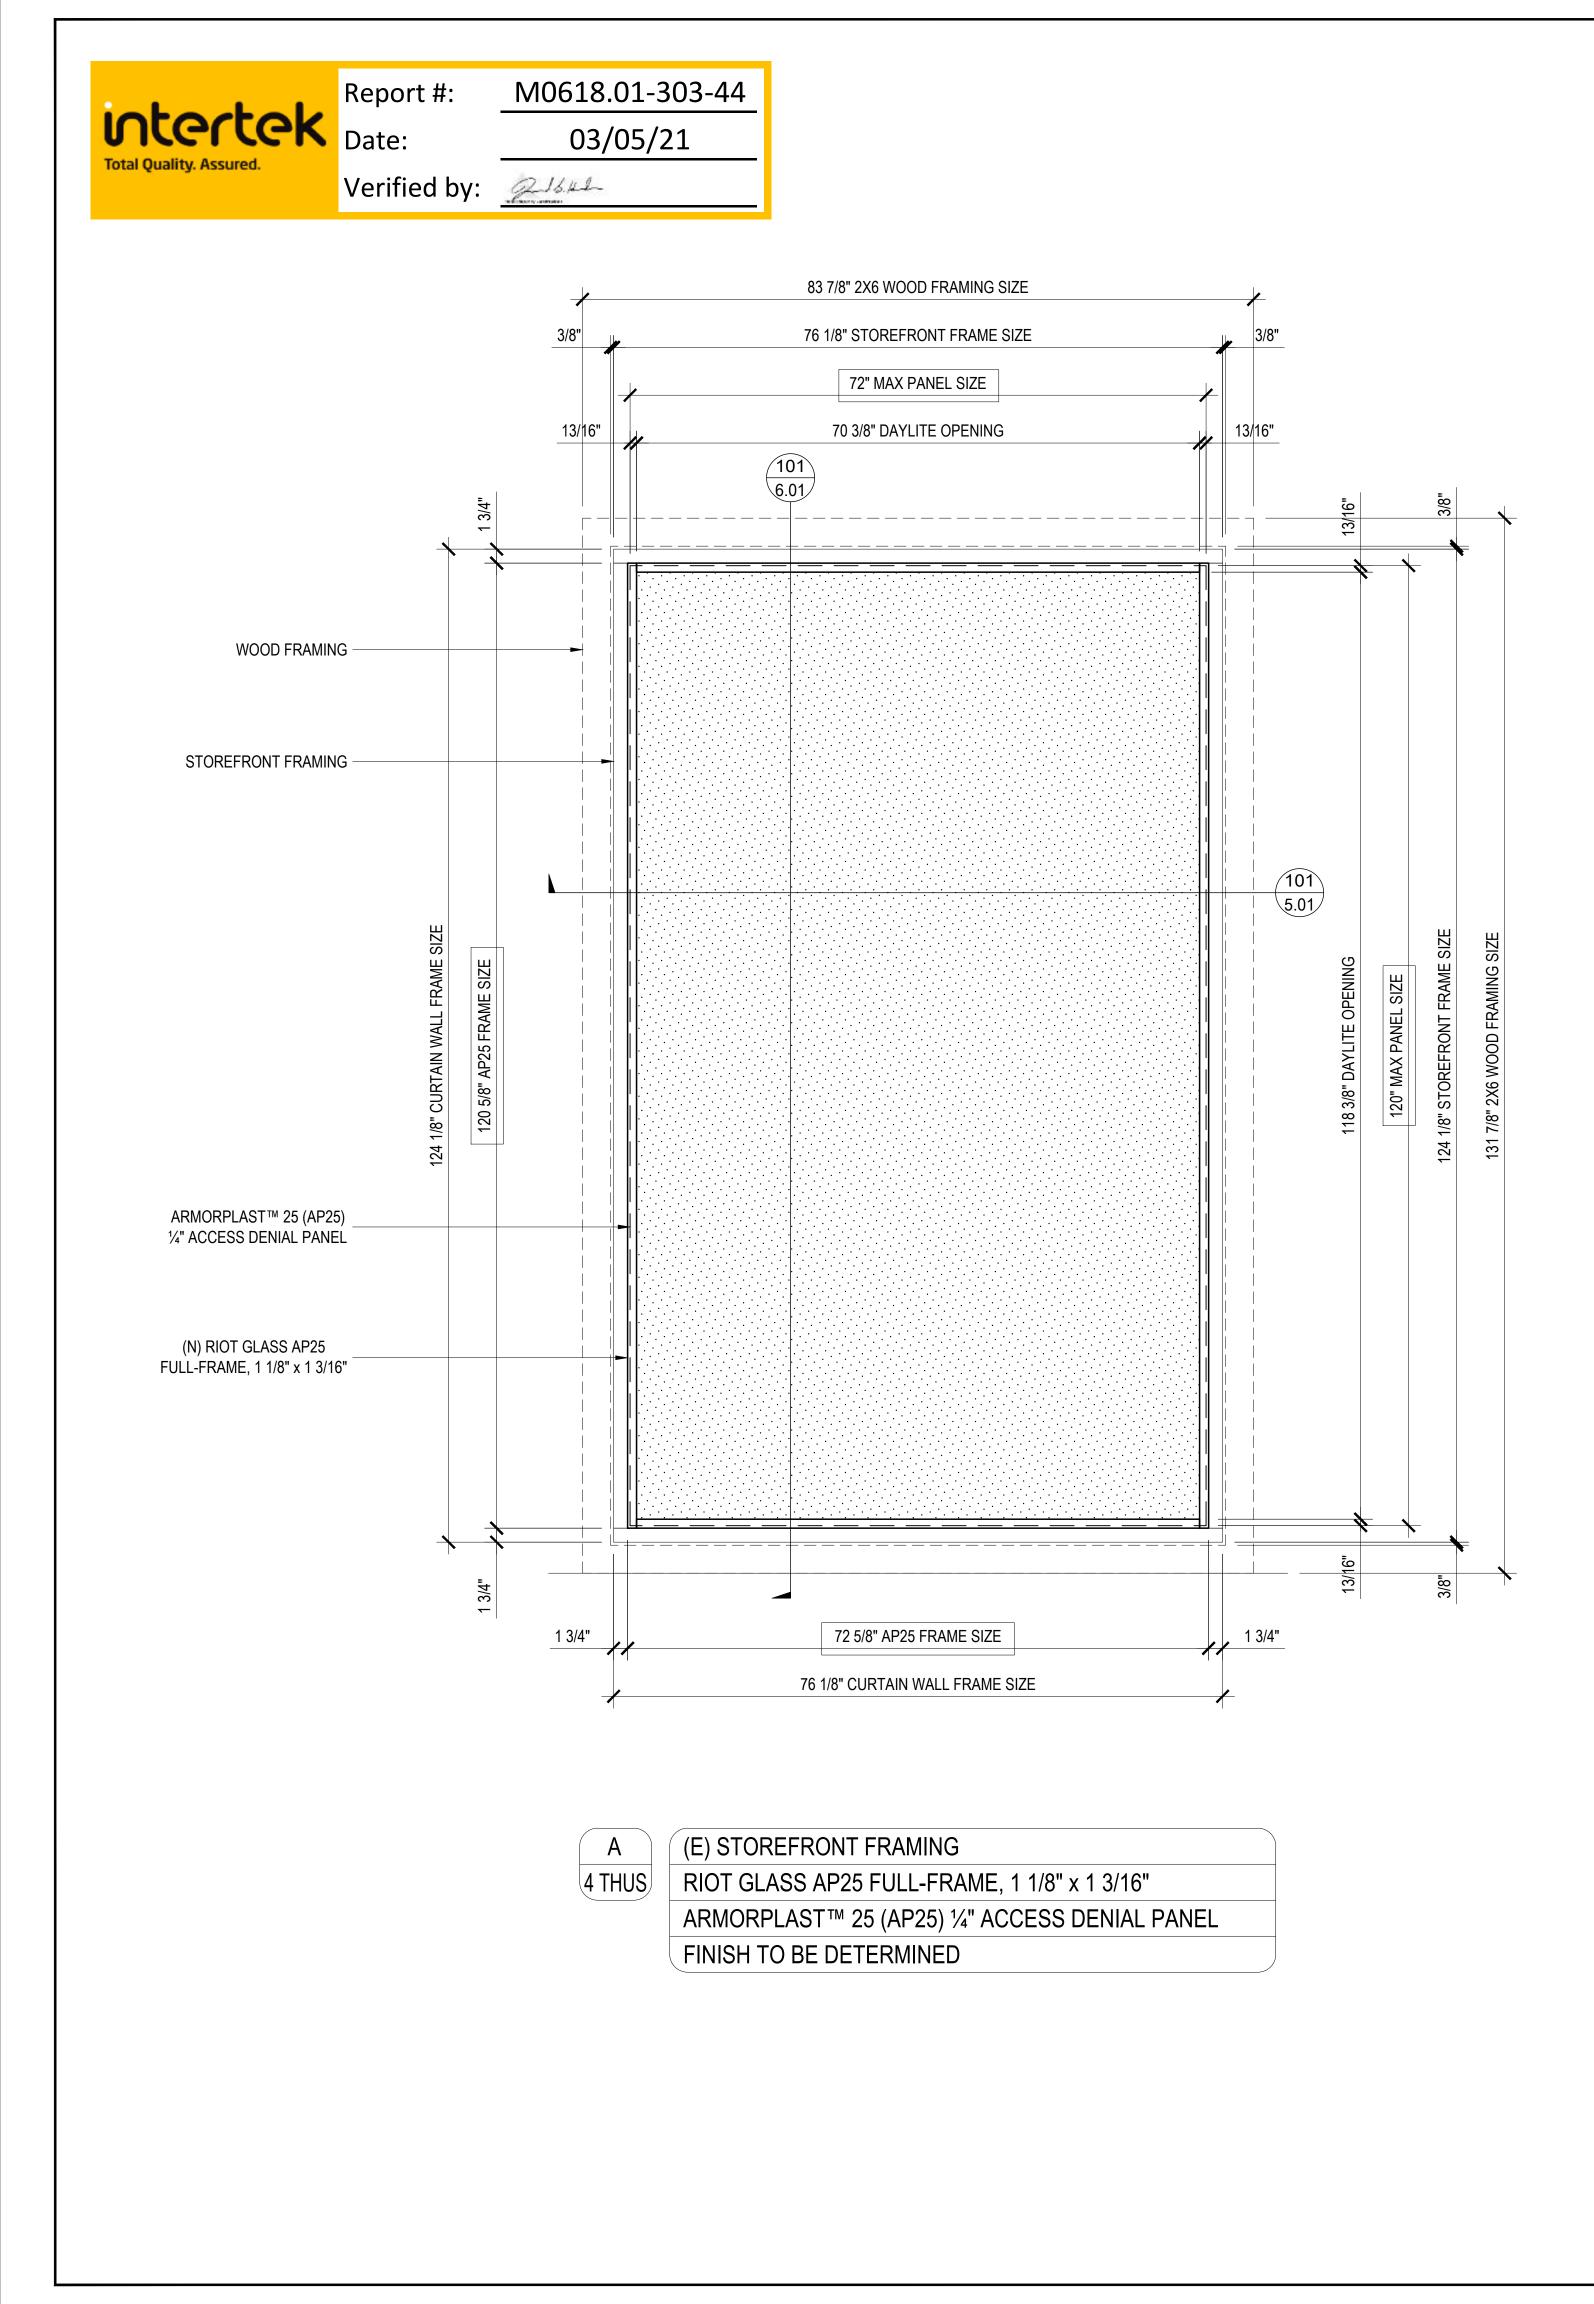

ARCHITECT OF RECORD'S APPROVAL	24"x36" PAPE
	THIS DRAWING IS NOT TO SCALE IF NOT PRINTED ON 24"x36" PAPE
STRUCTURAL ENGINEER OF RECORD'S APPROVAL	
STRUCTURAL ENGINEER'S APPROVAL	
GENERAL CONTRACTOR'S APPROVAL	
REVISIONS BY ¹ SF DIMENSIONS CHANGED TO 1.75"x4.00" TGM ¹ SF <th></th>	
RIOT GLASS, INC. 17941 BROOKSHIRE LANE HUNTINGTON BEACH, CA 92647 (800) 580 - 2303	
RIOT GLASS FRAMING DETAILS AVAILABLE IN USA & CANADA	
STOREFRONT ELEVATION AP-25 FULL FRAME	
DATE 1/15/2021 SCALE 1" = 1' - 0" DRAWN TGM JOB N/A SHEET V/A	ations_Details_12282020.dwg PLOTTED 1/18/2021 9:02 PM
2.01	ons_Details_12282

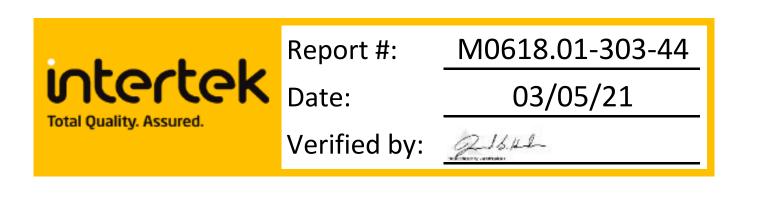

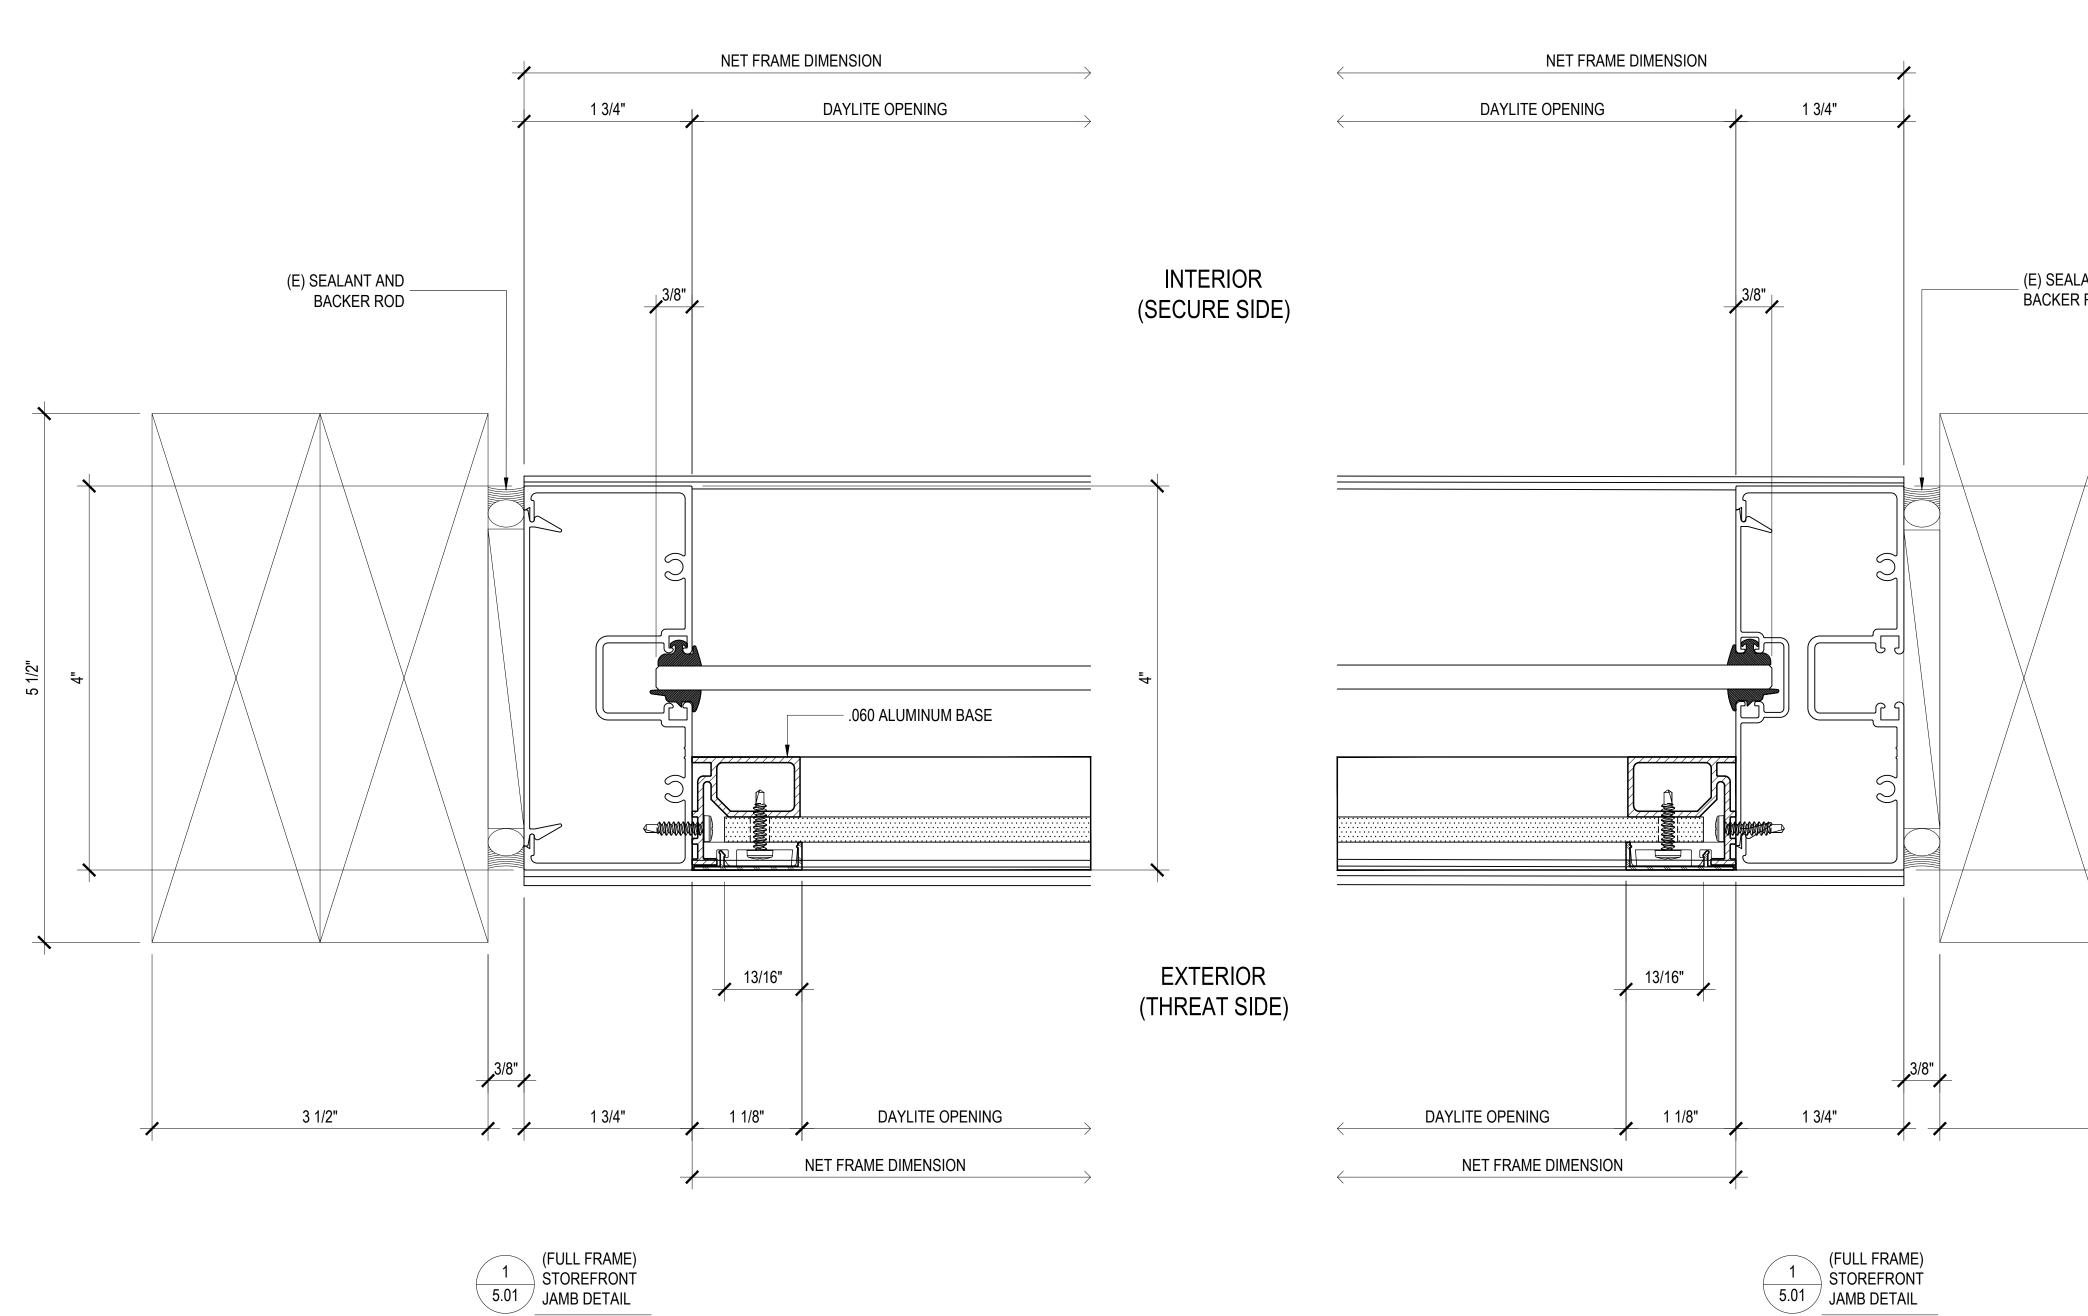

AP-25 FULL FRAME SYSTEM WITH SERIES 450 CENTER / INTERIOR GLAZED STORE


ARCHITECTURAL REF

ARCHITECTURAL REF

	STRUCTURAL ENGINEER OF RECORD'S APPROVAL
	STRUCTURAL ENGINEER'S APPROVAL
ANT AND ROD	GENERAL CONTRACTOR'S APPROVAL
	REVISIONS BY
3 1/2"	RIOT GLASS FRAMING DETAILS AVAILABLE IN USA & CANADA
	STOREFRONT DETAILS AP-25 FULL FRAME
FRONT SYSTEM	^{JOB} N/A SHEET 5.01

ARCHITECT OF RECORD'S APPROVAL



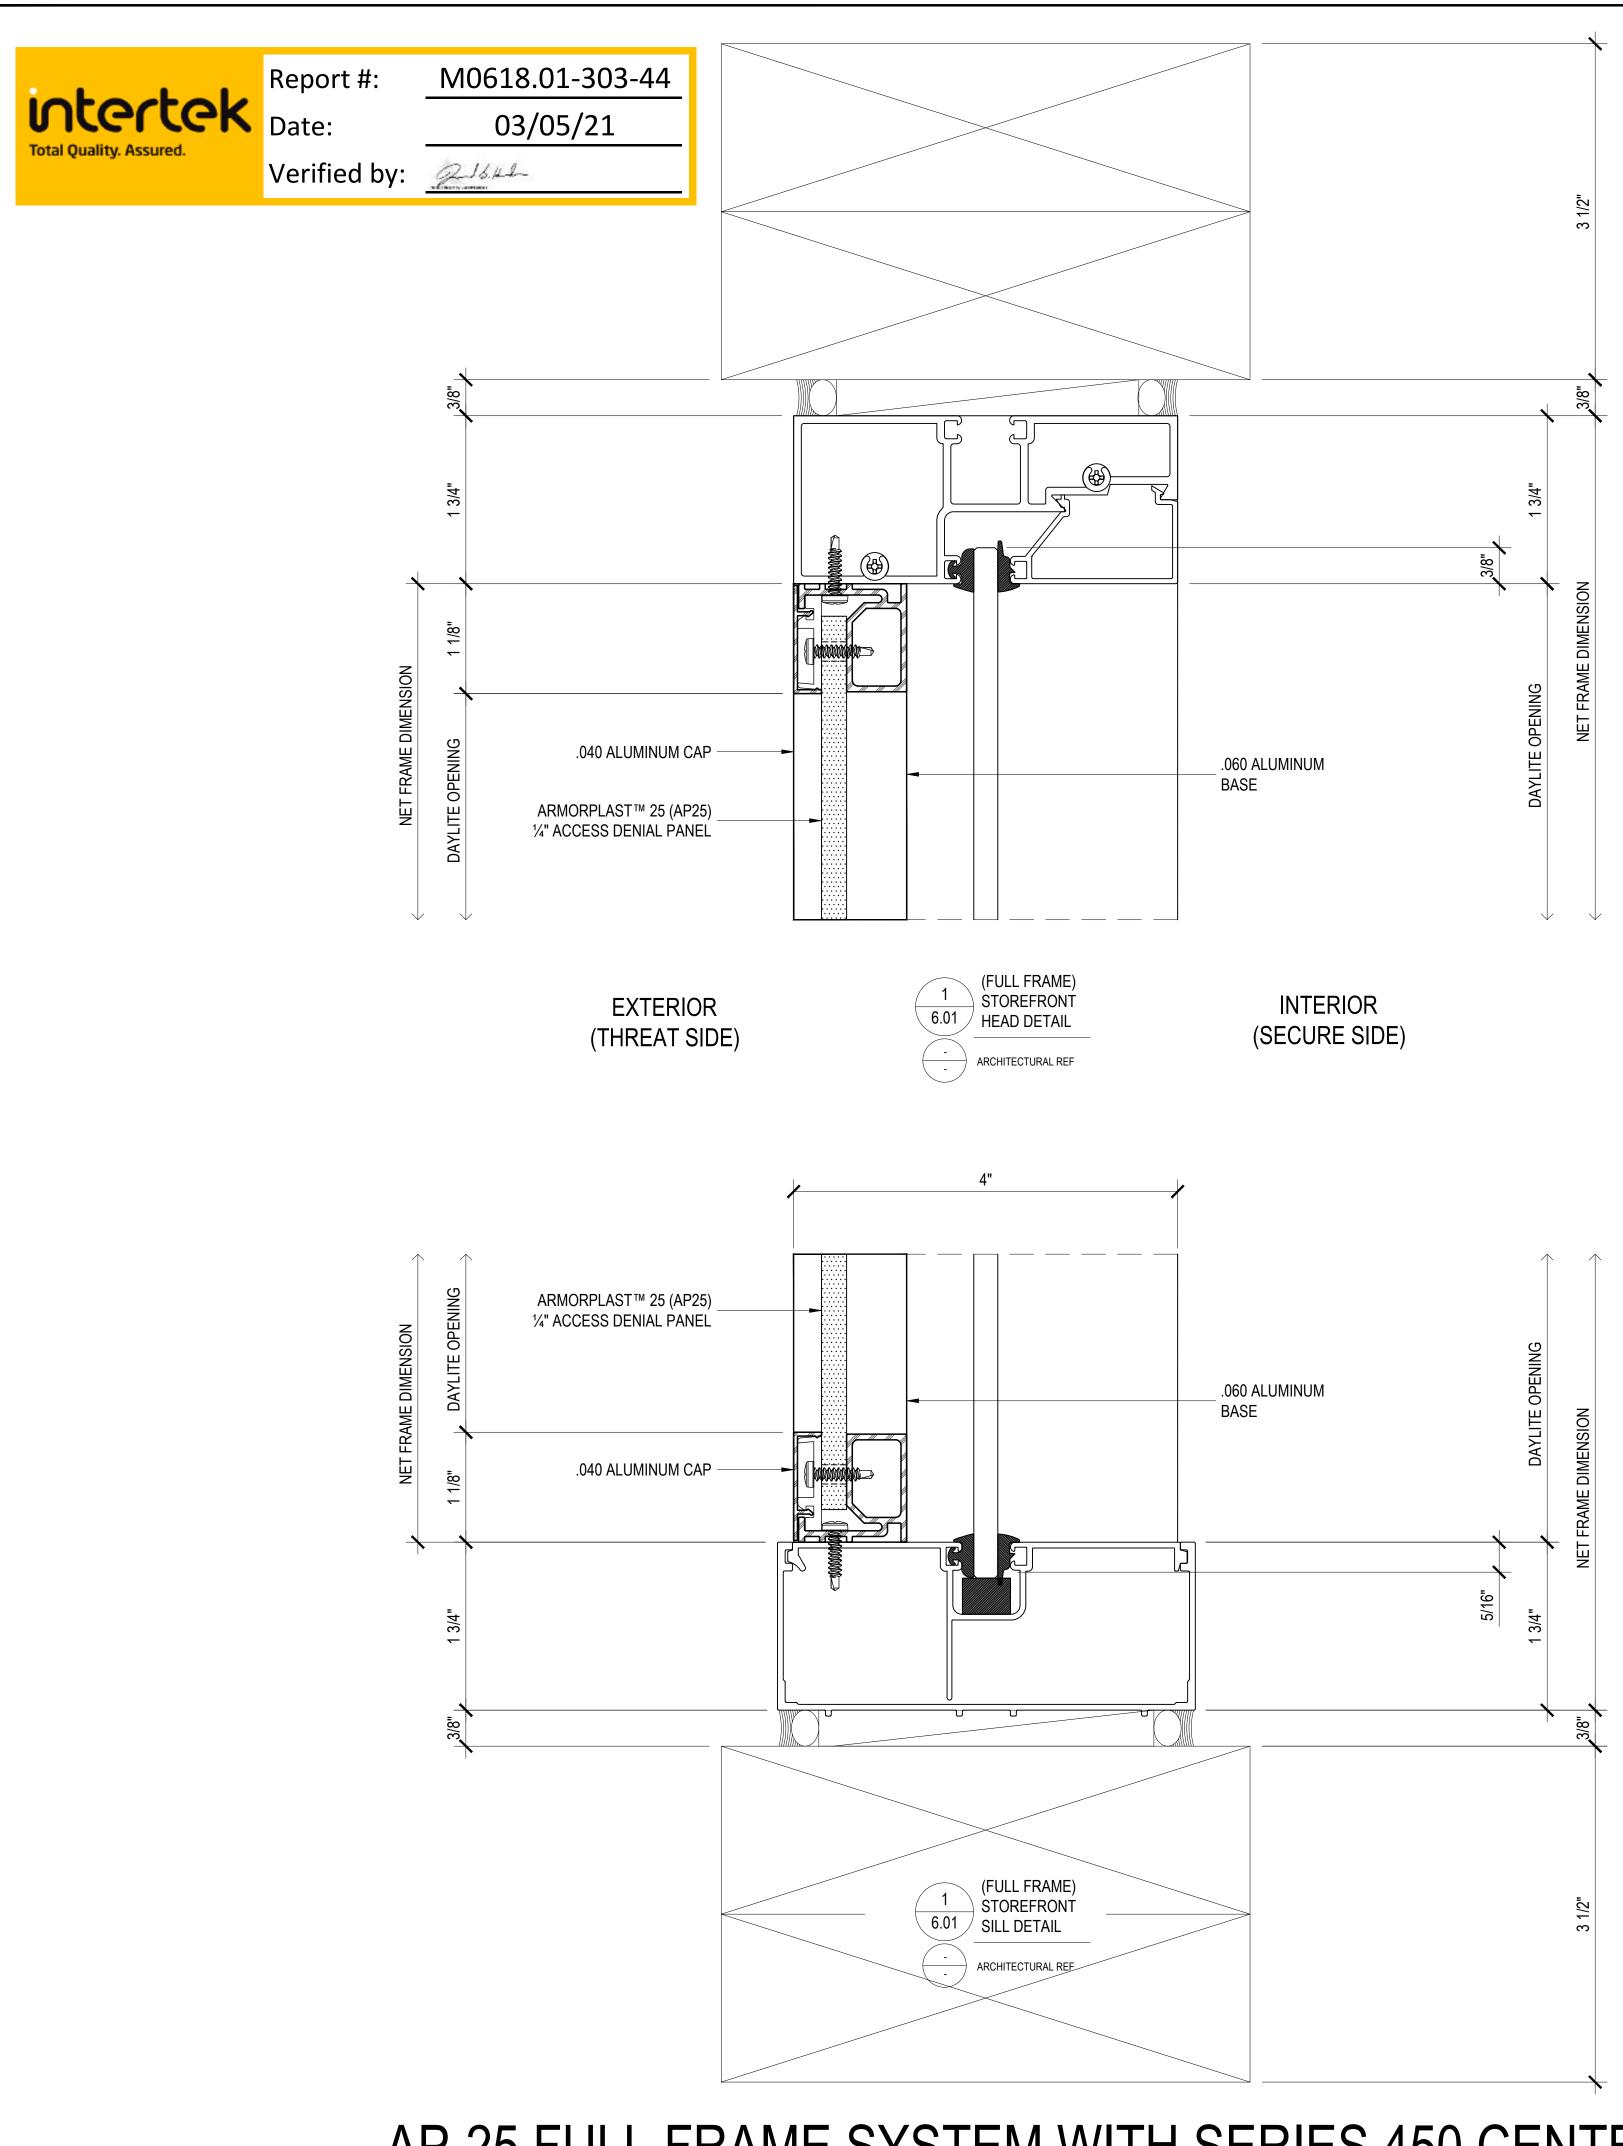

AP-25 FULL FRAME SYSTEM WITH SERIES 450 CENTER / INTERIOR GLAZED STOREFRONT SYSTEM

ARCHITECT OF RECORD'S APPROVAL
ARCHITECT OF RECORD'S APPROVAL
STRUCTURAL ENGINEER OF RECORD'S APPROVAL
STRUCTURAL ENGINEER'S APPROVAL
GENERAL CONTRACTOR'S APPROVAL
REVISIONS BY A SF DIMENSIONS CHANGED TO 1.75"x4.00" TGM A A
RIOT GLASS, INC. 17941 BROOKSHIRE LANE HUNTINGTON BEACH, CA 92647 (800) 580 - 2303
RIOT GLASS FRAMING DETAILS AVAILABLE IN USA & CANADA
STOREFRONT DETAILS AP-25 FULL FRAME
DATE 1/15/2021 SCALE 1' - 0" = 1' - 0"
SCALE 1' - 0" = 1' - 0"
6.01



25800 Commercentre Drive Lake Forest, California 92630

Telephone: 949-460-9600 Facsimile: 717-764-4129 www.intertek.com/building

TEST REPORT FOR RIOT GLASS, INC.

Report No.: M0618.01-303-44 Date: 03/05/21

SECTION 8

REVISION LOG

REVISION #	DATE	PAGES	REVISION
0	03/05/21	N/A	Original Report Issue